

CITY OF ANACORTES "AS-BUILT"

Sewer

Storm


CONTRACTOR: FISHER EXCAVATION

PLAT/DIVISION: _____ BLOCK _____

LOT ADDRESS: 2102 - 10TH ST

DATE: 5-28-15

PERMIT # _____ SCALE NOT TO SCALE

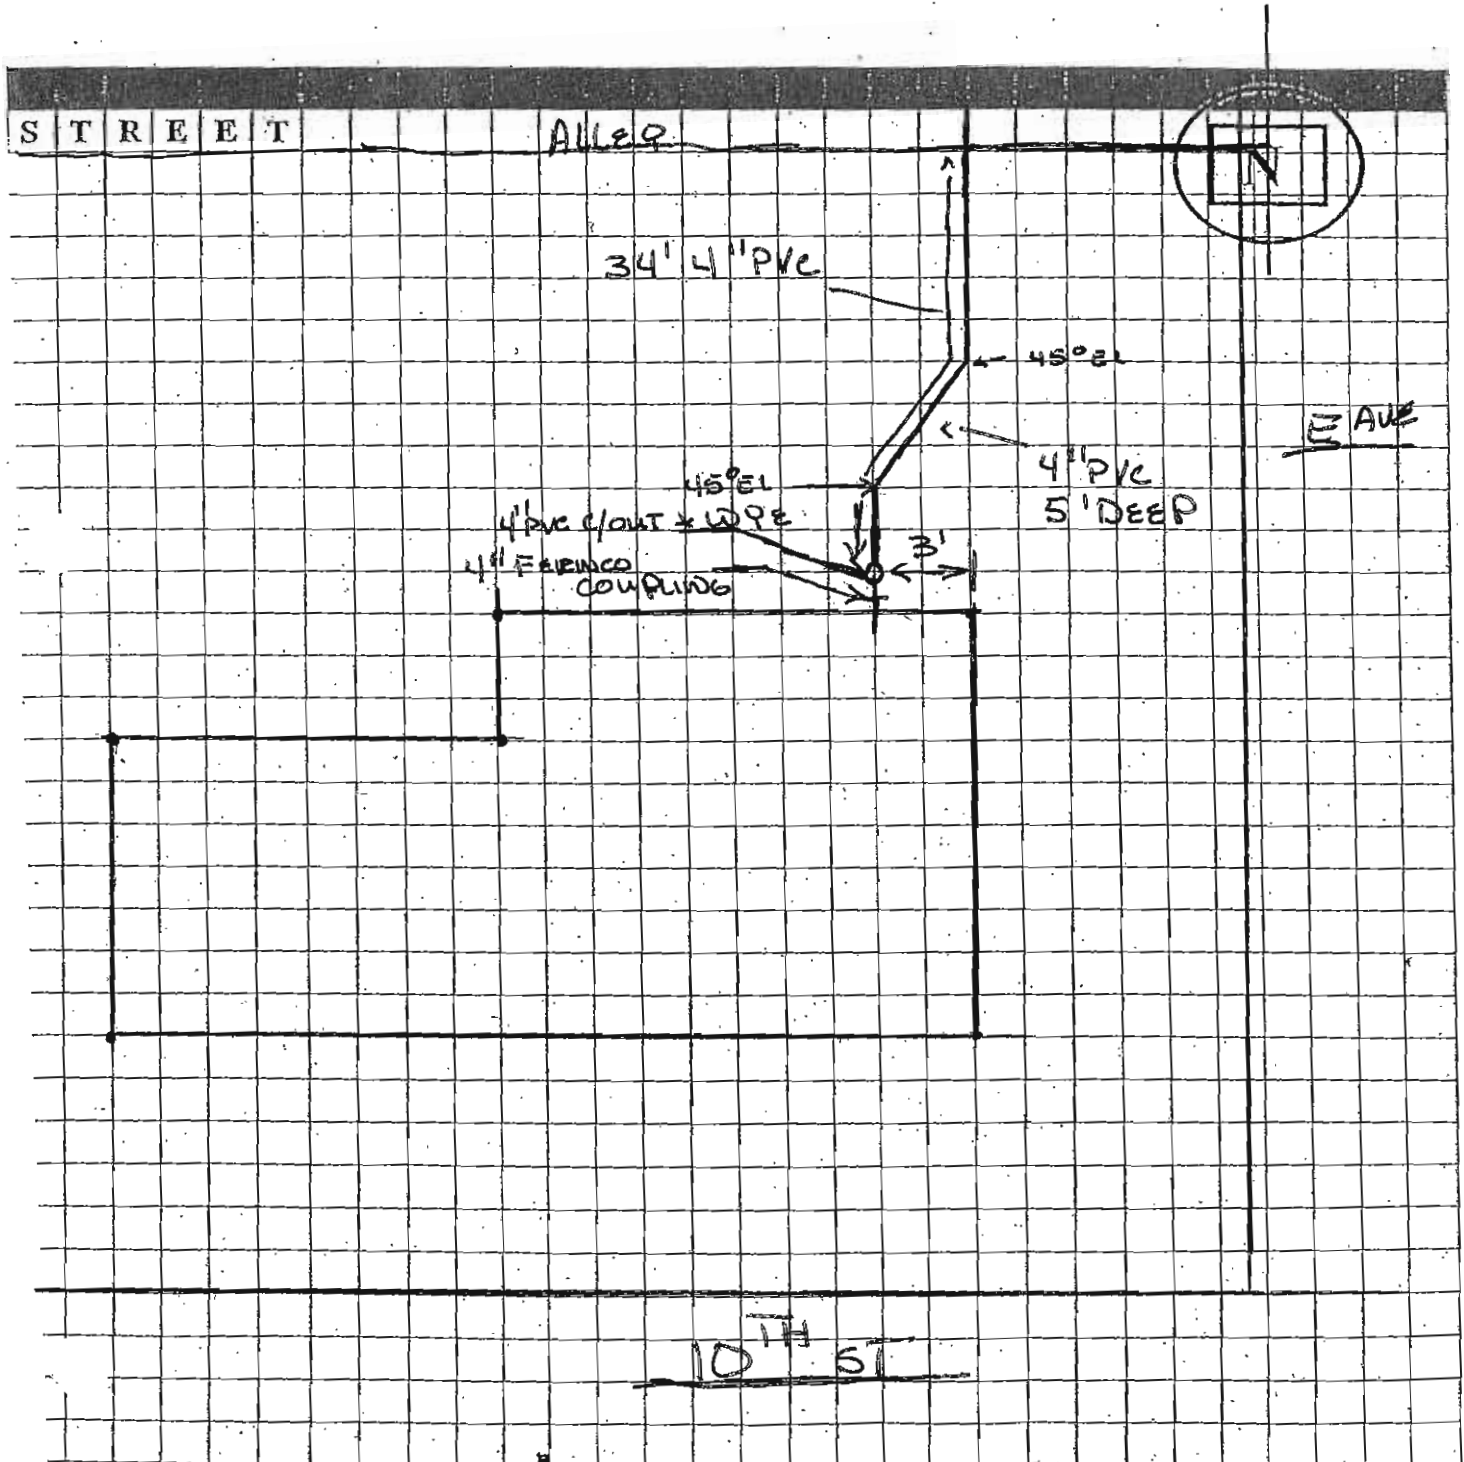

LOCATE STREET(S) ON GRID MAP



