



**CITY OF ANACORTES
WASHINGTON**

BUILDING DEPARTMENT

CERTIFICATE OF OCCUPANCY

This is to certify that the (Description of Building or Structure):

Single Family Residence

Located At: 1410 Kellogg
STREET & NUMBER

Owner: Joe Renfro

Constructed By: Mt Erie Construction
OWNER OR CONTRACTOR

Bldg. Permit # COM96-0189 Date Of Issue: 9-10-96

Occ. Group: R3 Use Zone: R2

Has Been Inspected And Occupancy Is Hereby Authorized.

This June Day Of 23rd 19 97.


Robert Osborne
AUTHORIZING OFFICIAL

SEE REVERSE SIDE FOR SPECIAL REQUIREMENTS.



Sewer
Asbuilt

12-6-96

Decker

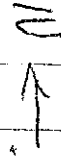

Prop.

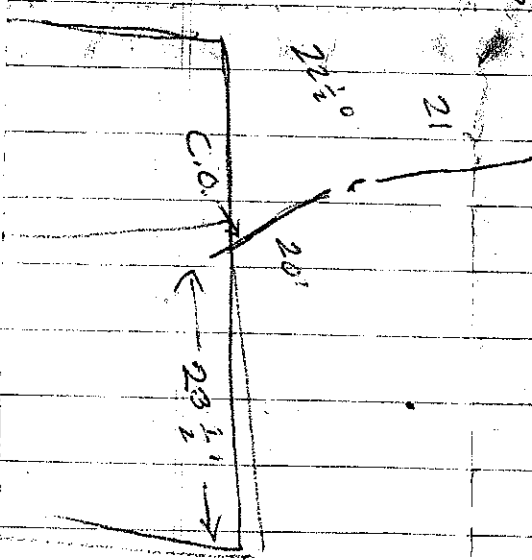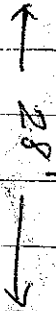

1410
Kellogg Ave