

CITY OF ANACORTES
BUILDING DEPARTMENT

CERTIFICATE OF OCCUPANCY

F 884

THIS IS TO CERTIFY that the (description of building
or structure): Single Family

Residence

Owner: Donald R. Wood

Street and No.: 3917-Mallard Point

Contractor: M. L. Skaver ^{Contract} Fire Zone: N.A.

Building Permit No.: 2745

Occ. Group: R3 Use Zone: RM

has been inspected and occupancy is hereby
authorized:

9-14 1981
Ray Jensen
Building Inspector

CITY OF ANACORTES

BLDG. PLUMBING MECHANICAL

PERMIT 2745

ANACORTES, WASH.

DATE 5-1 19 81

PERMISSION IS HEREBY GRANTED TO:

OWNER Donald R Wood

STREET ADDRESS 3917 - Mallard Point
LOCATION WHERE WORK IS TO BE DONE

CONTRACTOR M. L. Shaver Contr.

TO ERECT INSTALL OR REPAIR

IN THE FOLLOWING MANNER: New Residence on 1/2 acre plot
Plan corrected bldg plans & plan book handout - no
changes without permission of Bldg Dept
Plumb. permit = I. F. + W. S. + 19 Utilities
Mech. permit = gas piping for furnace hot pump
 PERMIT EXPIRES ONE YEAR FROM DATE ISSUED FF. 00


PLANS FOR CONSTRUCTION WERE NOT SUBMITTED
 WERE SUBMITTED
 WORK TO BE DONE BY OWNER CONTRACTOR

RECEIPT OF FEES IS ACKNOWLEDGED AS FOLLOWS:

TYPE	APPROXIMATE VALUE OF WORK		PERMIT FEES	
ISSUING				6 00
BUILDING	150,000	00	362	00
GAS PIPING	50	00	3	00
PLUMBING AND W.S.	4,000	00	40	00
SEWER CONNECTION INSP.			75	00
MECHANICAL	5,500	00	11	00
PLAN CHECK FEE			75	00
MISC.				
TOTAL	158,500	00	512	00

LEGAL DESCRIPTION Lot 6 Stittwood Div 1

Ray Shaver
 CITY INSPECTOR

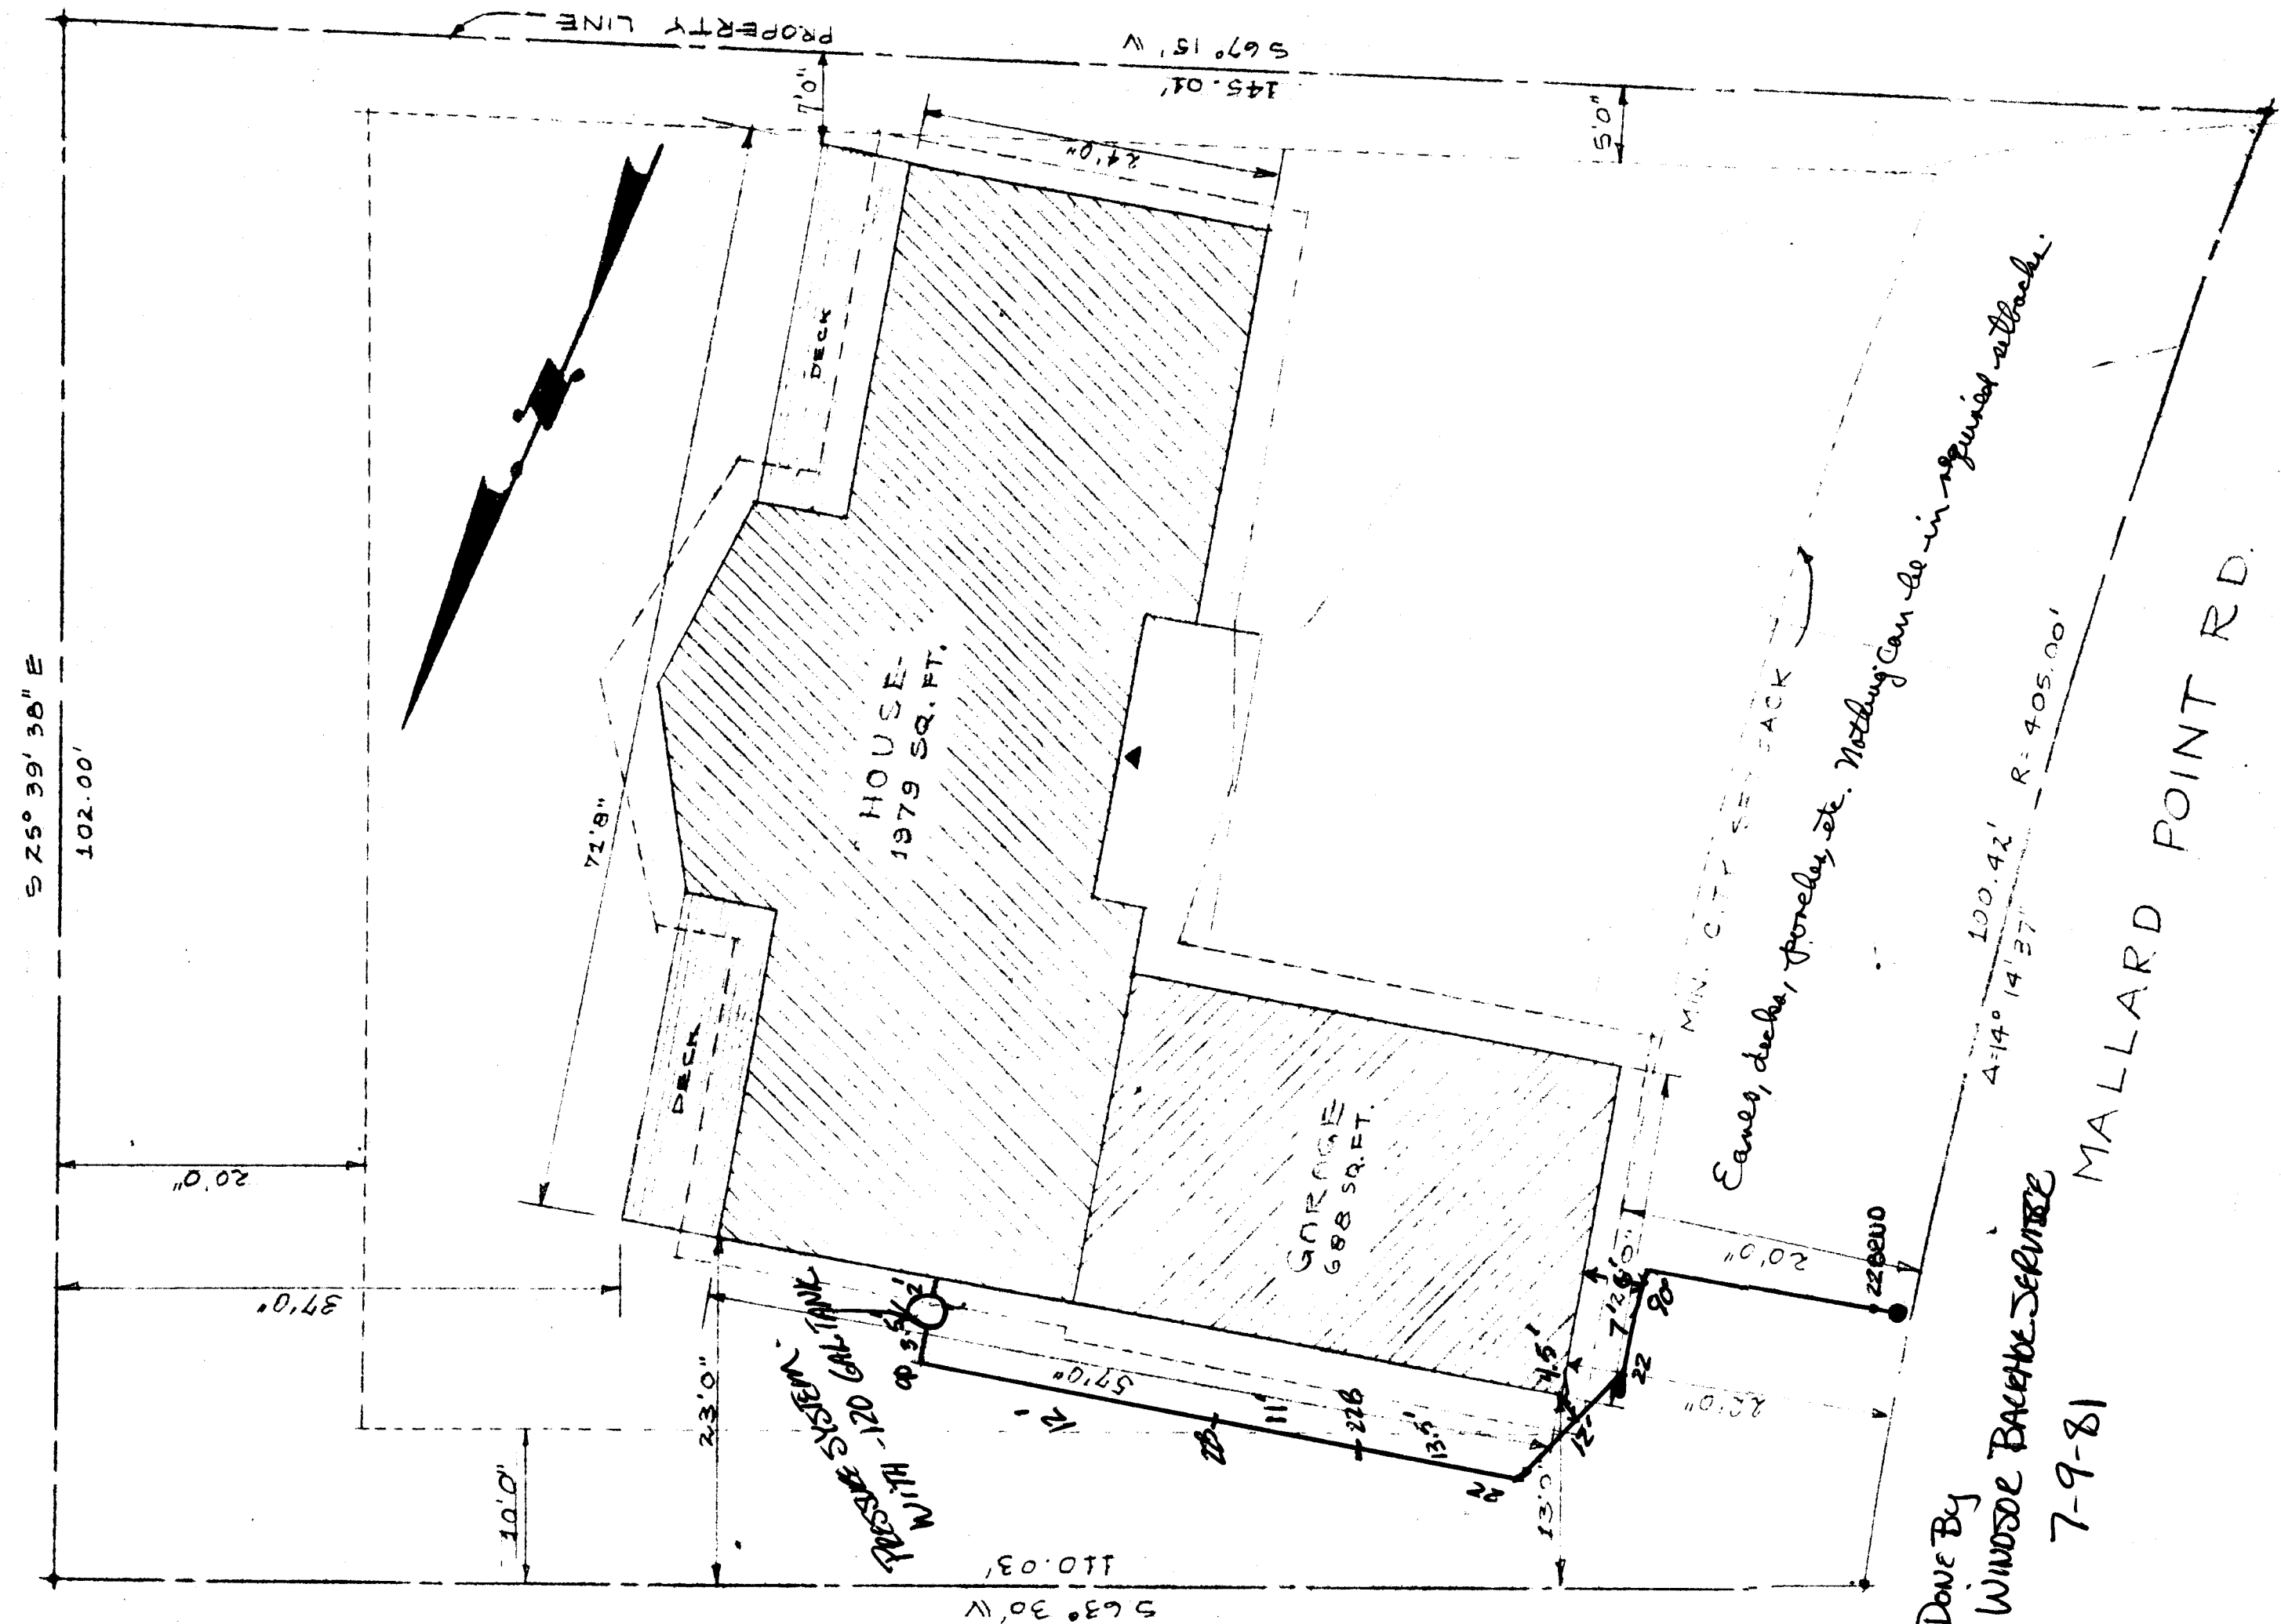

Done By
WINDSIDE BACHELOR SERVICE
7-9-81

PLOT PLAN

SCALE: 1" = 10' 0"

LEGAL DESCRIPTION
LOT #6, STITTWOOD ^{PI} ADDITION TO
THE CITY OF ANACORTES, COUNTY
OF SKAGIT, STATE OF WASHINGTON.

GLEN A. DAVISON DRAFTING & DESIGN SERVICE
 721 NO. 15TH MOUNT VERNON, WASHINGTON ZIP: 98213
 PHONE: 336-9853

PREPARED FOR:
MR. & MRS. DONALD R. WOODS
 NAPERVILLE, ILLINOIS
 DRAWN BY: J.P.D. DATE: APRIL 10, 1981
 3917 MALLARD POINT RD.